



Kachemak City Sewer ID Map


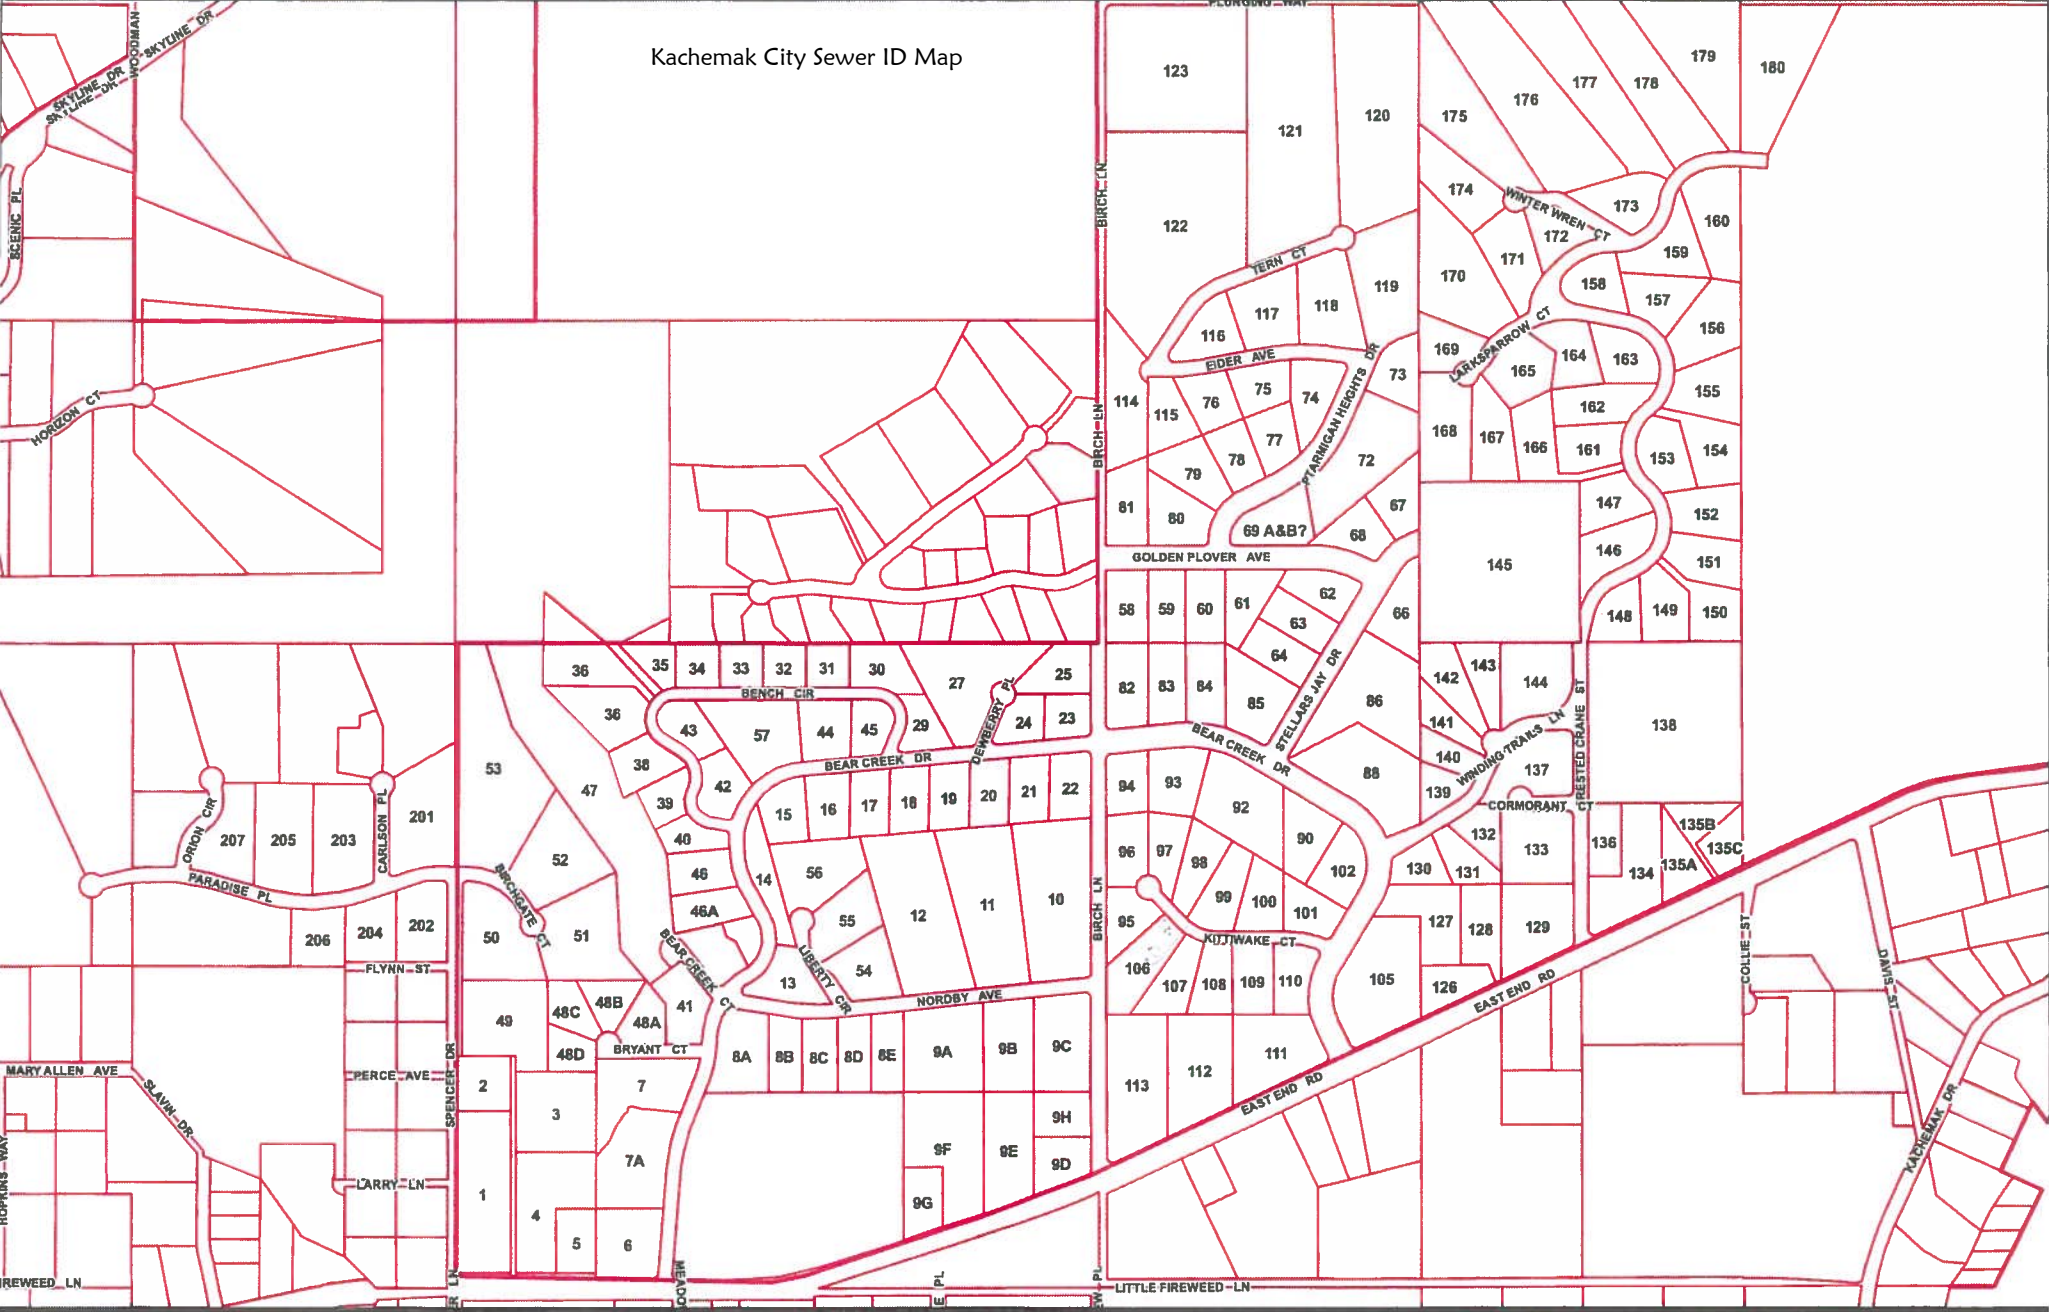


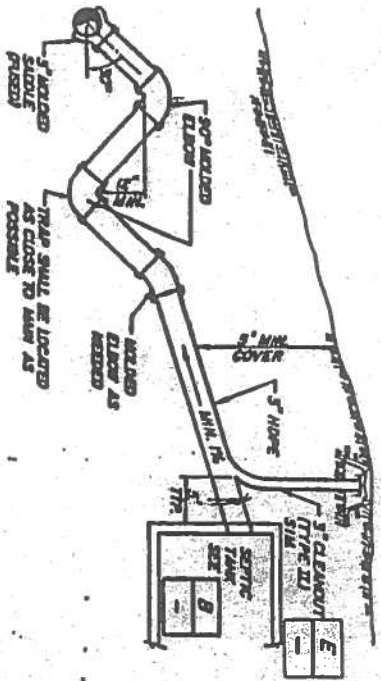

NOTE: SEWER LATERAL SHALL BE BORED OR UNDISTURBED BENEATH SOIL. ANY OVEREXCAVATION SHALL BE BACKFILLED WITH TYPE I BACKFILL. CLEANOUTS TO 5\"/>


TYPICAL SEWER SERVICE LATERAL (TYPE II)

DATE	1
REVISIONS	

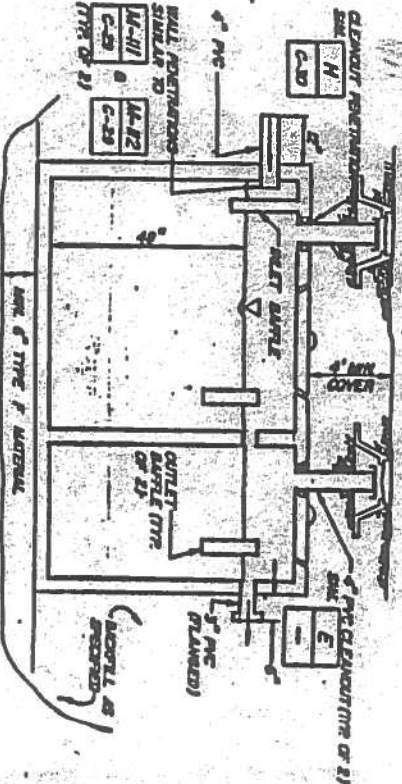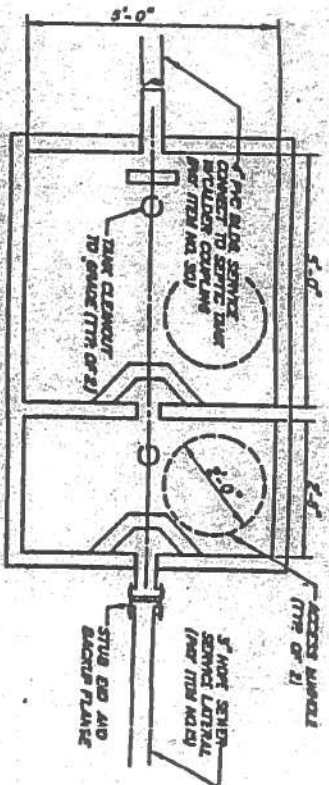

REINFORCED CONCRETE SEPTIC TANK


DATE	2
REVISIONS	

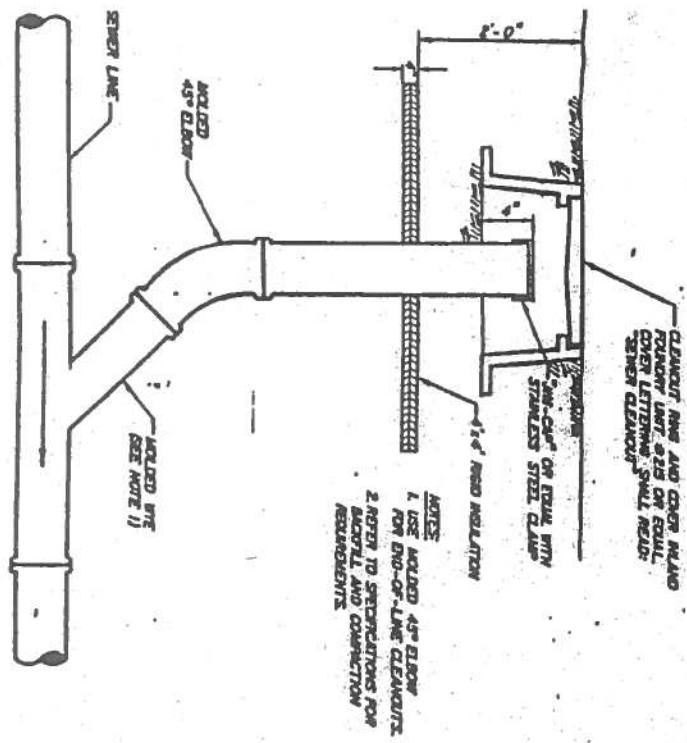

NOTES:
1. USE ANGLER 45° ELBOW FOR 90°-OF-LINE CLEANOUTS.
2. REFER TO SPECIFICATIONS FOR BACKFILL AND COMPACTON REQUIREMENTS.

SEWER LINE CLEANOUT (TYPE II)

DATE	3
REVISIONS	

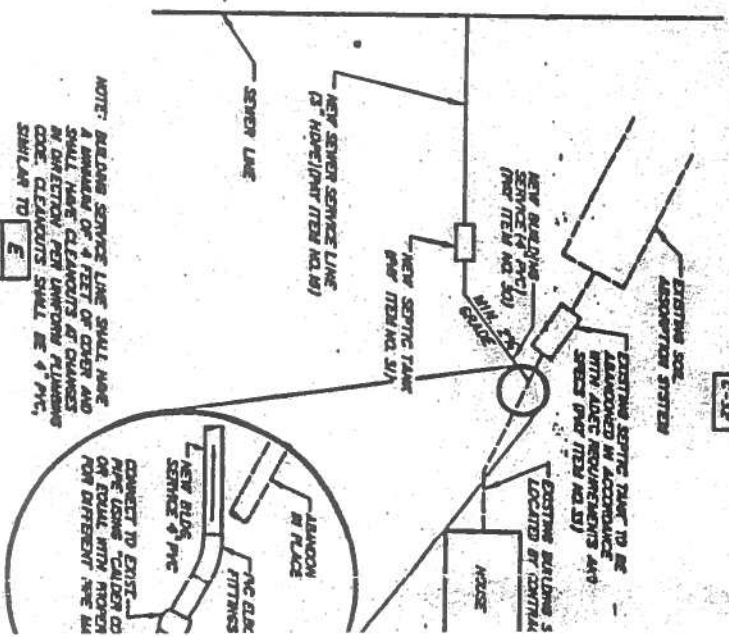

NOTE: BUILDING SERVICE LINE SHALL HAVE A MINIMUM OF 4 FEET OF COVER AND SHALL HAVE CLEANOUTS AT CHANGES IN DIRECTION FOR UNIFORM FLOWING. CLEANOUTS SHALL BE 4\"/>

TYPICAL SEWER SERVICE

NOT TO SCALE

NO.	DATE	DESCRIPTION

SCALE:

DESIGNED BY	L. ENOGLAN
DRAWN BY	D. DAVIS
CHECKED BY	R. VAUSE
DATE	


SUBMITTED BY
James M. Montg
PROJECT ENGINEER

RECOMMENDED BY
James M. Montg
PROJECT ENGINEER

CE 53-30
FACT NO. 1178
DATE 11/18/89
BY *James M. Montg*

JAMES M. MONTG
CONSULTING ENGINEER




MAKE CORRECTIONS NOTED IN XI REVIEW BY: LMT/LB
 REVIEWED BY: LMT/LB
 RECOMMENDED BY:
 CONDITIONS OR COMMENTS MADE ON CONTRACTOR'S SHOP DRAWINGS DURING THIS REVIEW DO NOT RELIEVE THE CONTRACTOR FROM COMPLIANCE WITH CONTRACT DRAWINGS AND SPECIFICATIONS THIS SHOP DRAWING HAS BEEN REVIEWED FOR COMPLIANCE WITH THE ABOVE CONTRACT AND GENERAL COMPLIANCE WITH THE CITY ENGINEERING DEPARTMENT. CONTRACTOR IS RESPONSIBLE FOR VERIFYING AND CORRELATING ALL DIMENSIONS AND DIMENSIONS OF ALL TRADES AND COORDINATING WITH ALL OTHER TRADES, AND SATISFACTORY AND SAFE PERFORMANCE OF THE WORK.

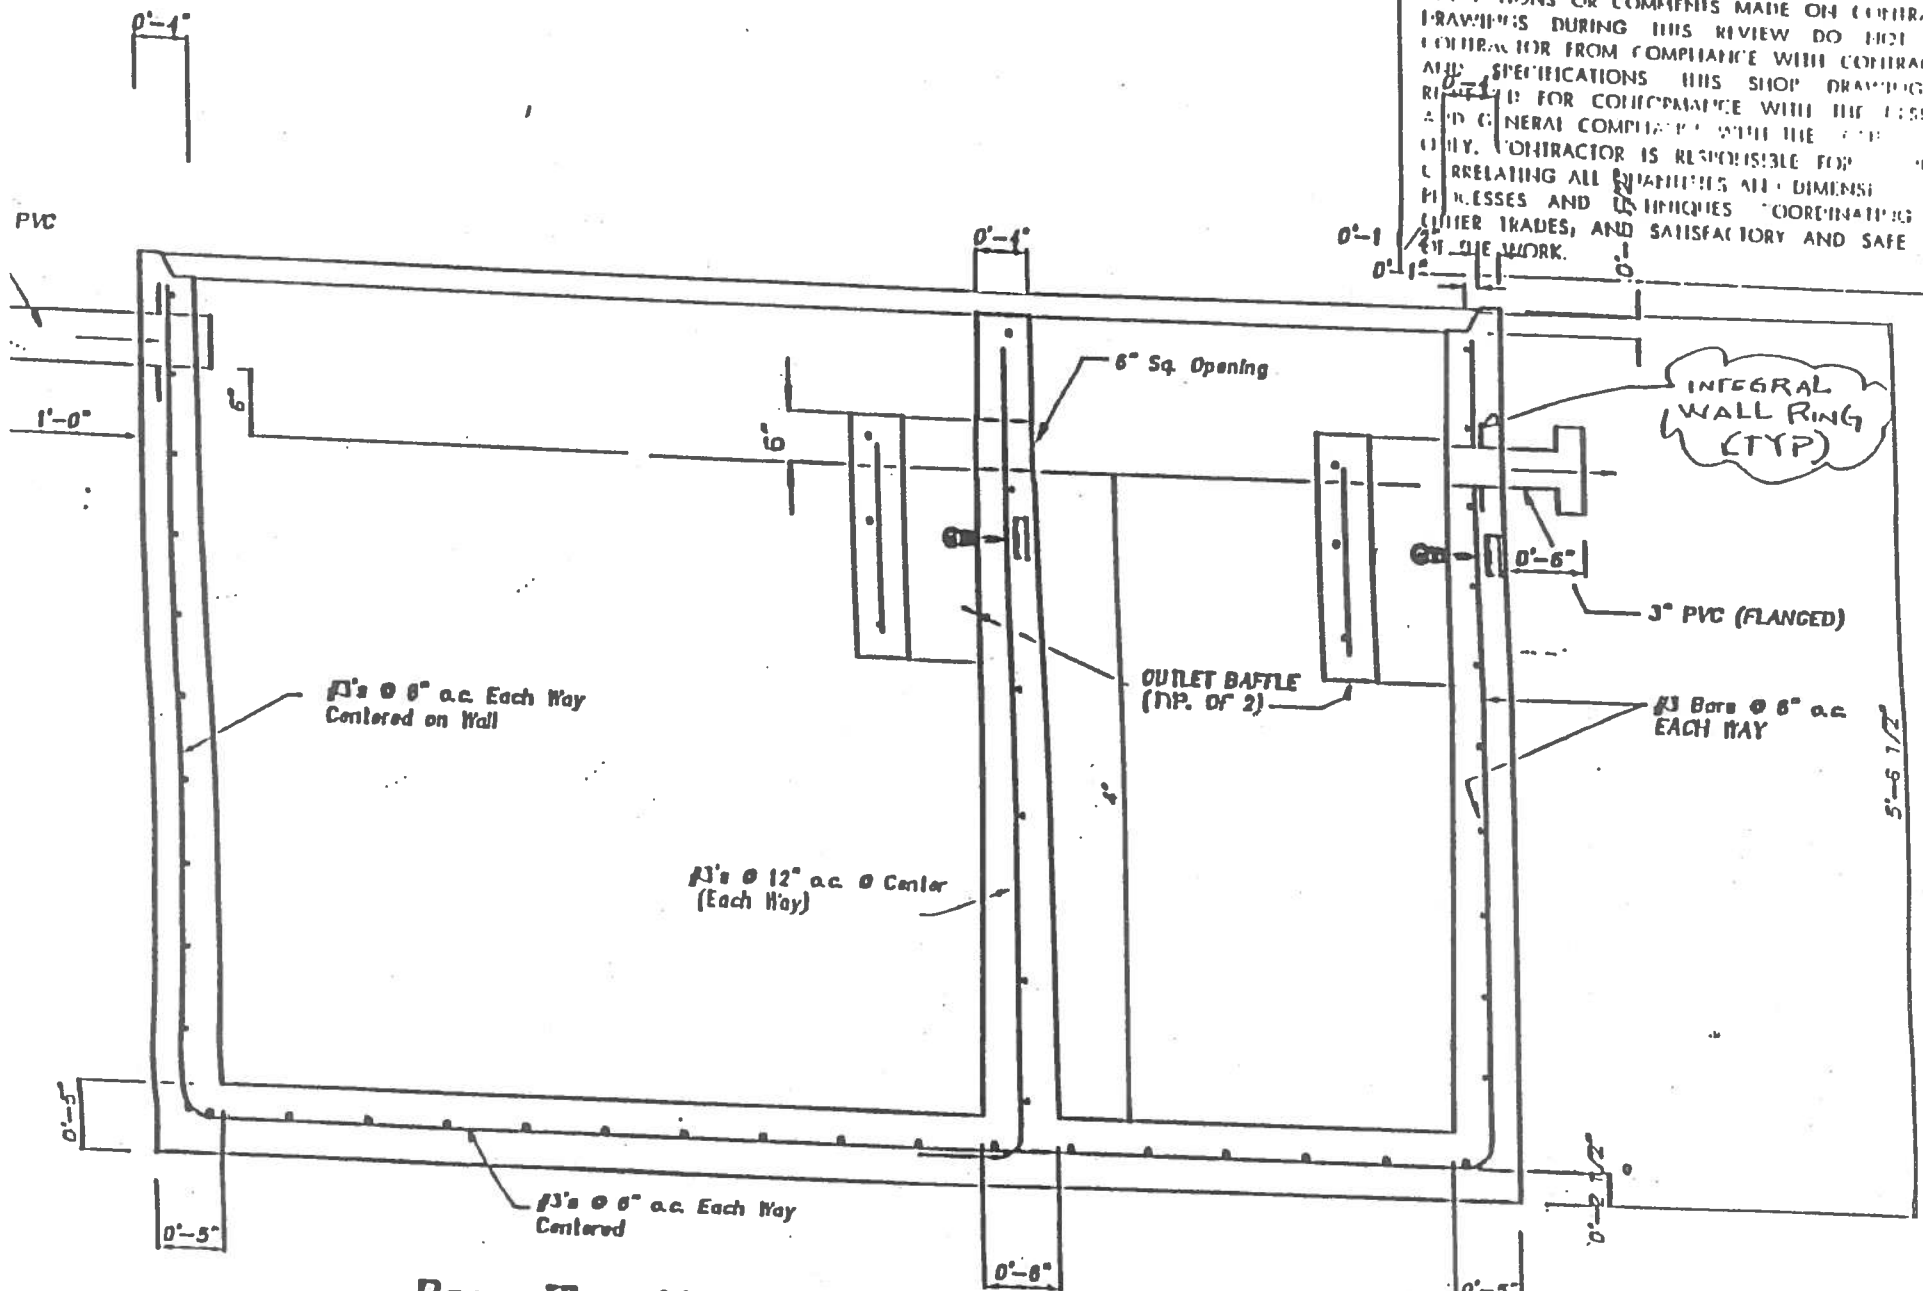

Base Elevation Section

THE DUCT AND INSERT ARE SEALED AGAINST CORROSION (TYP)

REVIEWED BY: LMT/LB
 RECOMMENDED BY:
 COMMENTS MADE ON CONSTRUCTION DURING THIS REVIEW DO NOT
 TAKE PRECEDENCE FROM COMPLIANCE WITH CONTRACT
 AND SPECIFICATIONS THIS SHOP DRAWING
 REVIEWED FOR CONFORMANCE WITH THE DESIGN
 AND GENERAL COMPLIANCE WITH THE CONTRACT
 ONLY. CONTRACTOR IS RESPONSIBLE FOR
 CORRELATING ALL QUANTITIES AND DIMENSIONS
 PROCESSES AND TECHNIQUES TO THE PROJECT
 OTHER ACCESS MANIFOLD SHALL BE COORDINATED
 OF THE (TYP. OF 2)
 See Lid Plan

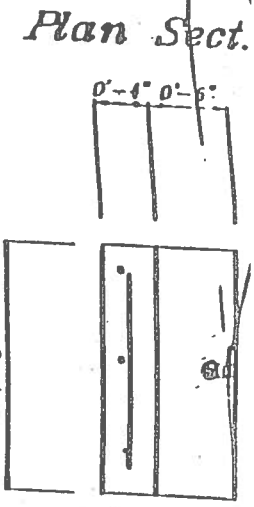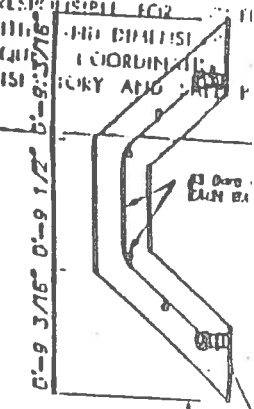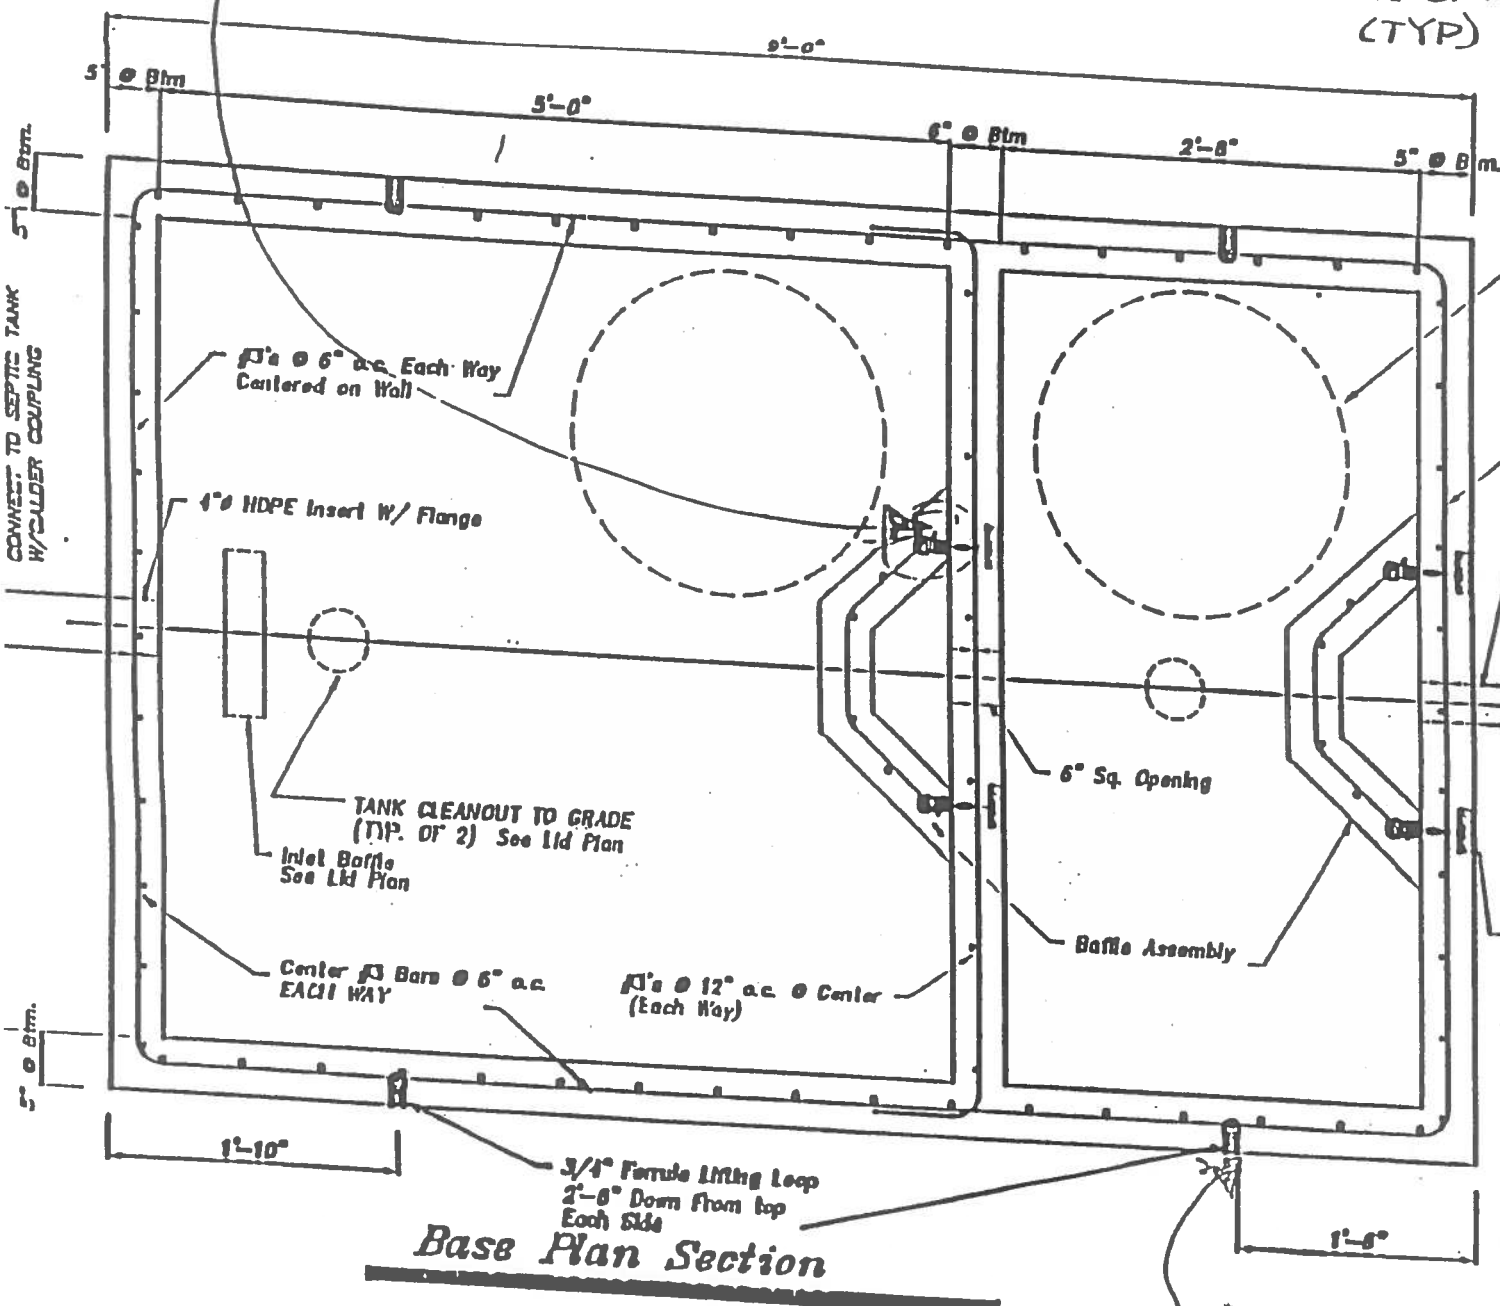

Plan Sect.

Elev. Sect

Outlet Bay

RECESS LOOP 1/2" MIN.
 + FILL W/ EPOXY GROUT
 AFTER TANK IS IN
 PLACE (TYP)

Base Plan Section