STATE	PROJECT DESIGNATION	YEAR	SHEET NO	TOTAL SHEETS
ALASKA	F 021-1 (10)	1962	31	58
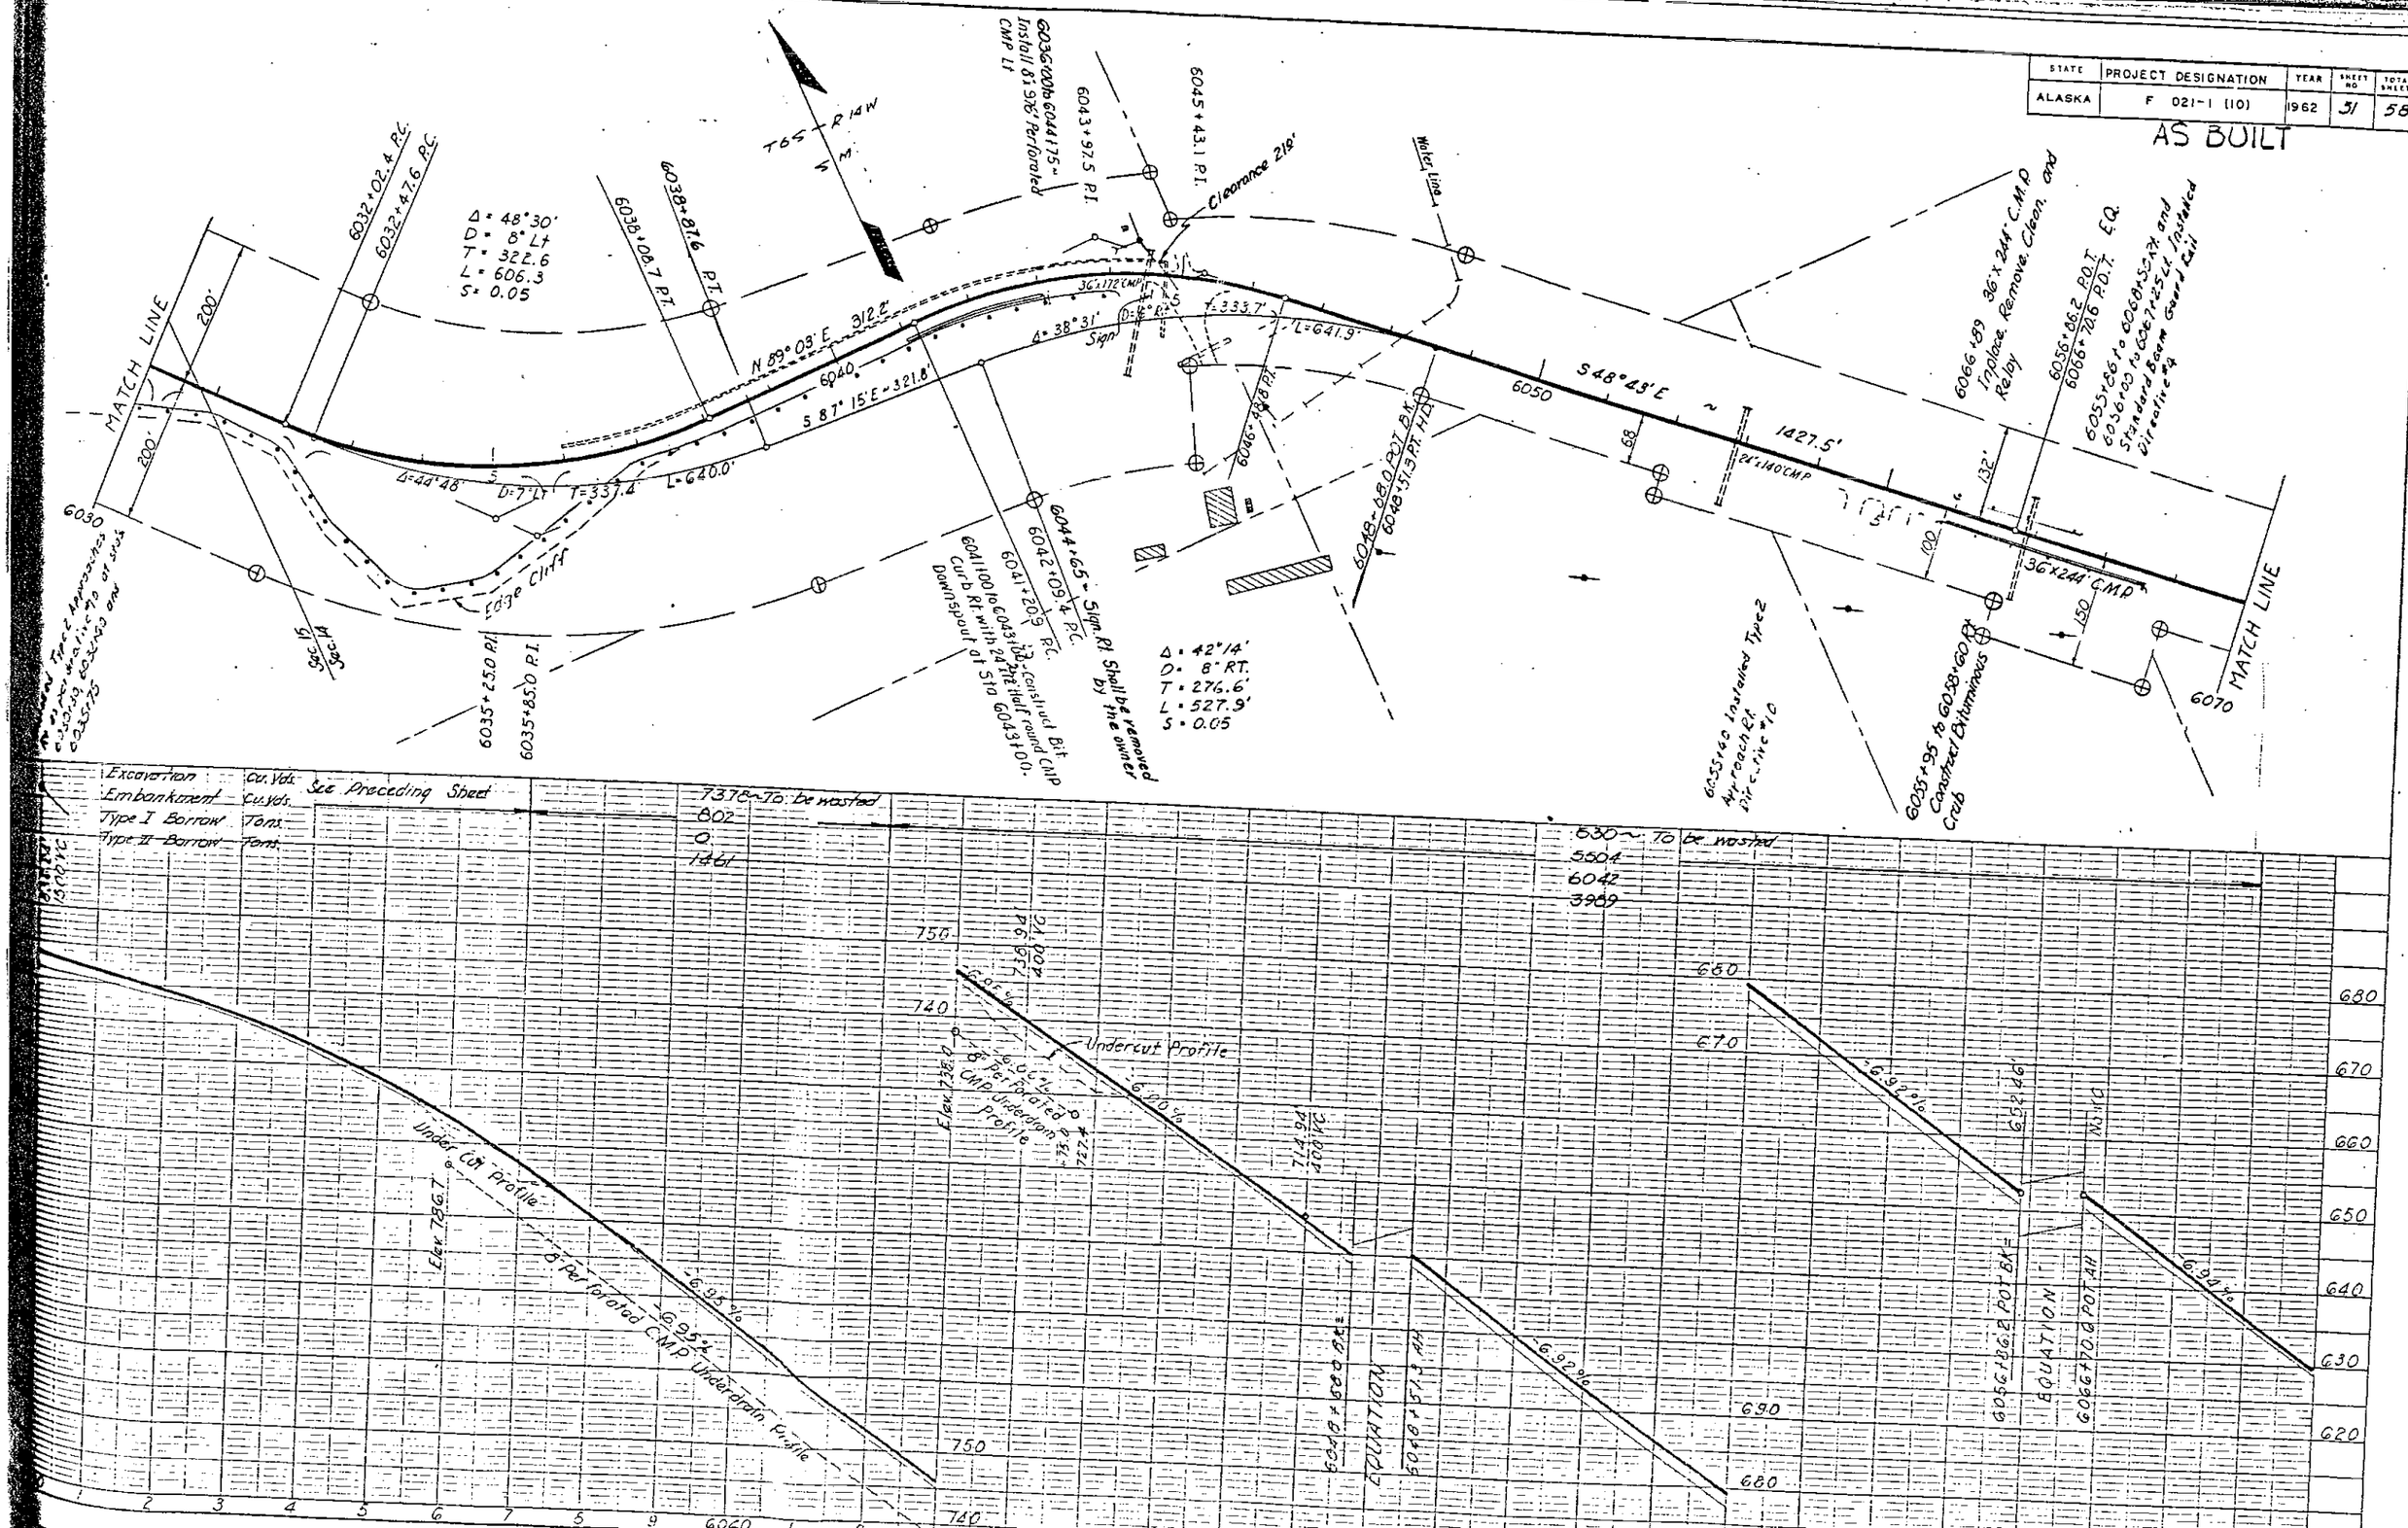
AS BUILT