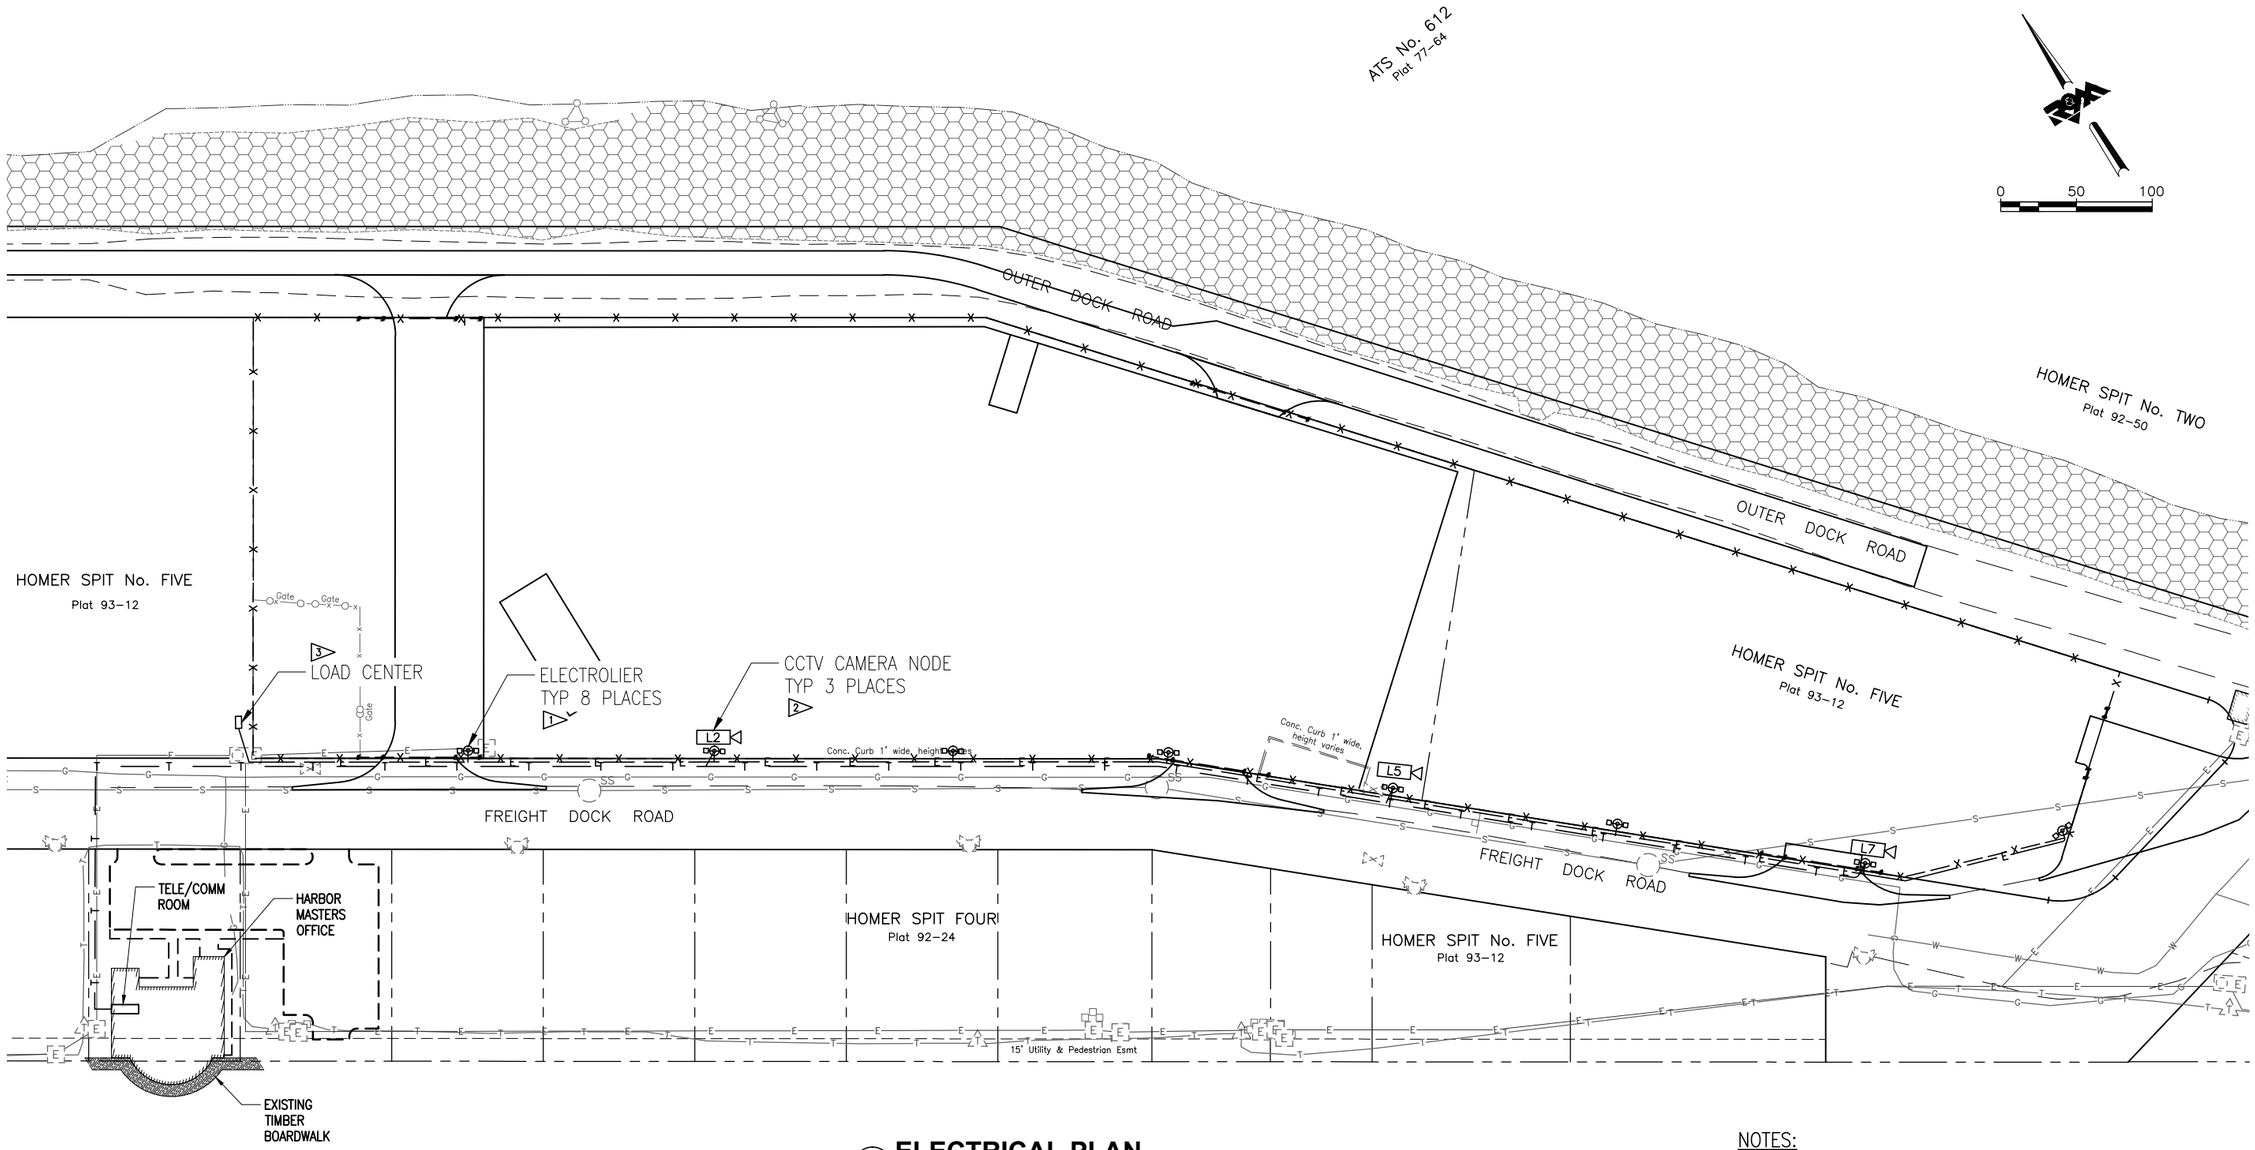

1 ELECTRICAL PLAN

Scale: 1"=50'

NOTES:

1. PROVIDE ELECTROLIERS IN ACCORDANCE WITH THE TYPICAL ELECTROLIER ELEVATION DETAIL.
2. PROVIDE CCTV CAMERA NODES IN ACCORDANCE WITH THE TYPICAL CAMERA SITE ELEVATION DETAIL.
3. PROVIDE LOAD CENTER AND UNDERGROUND ELECTRICAL PATHWAYS IN ACCORDANCE WITH THE POWER SYSTEM ONE-LINE DIAGRAM.
4. PROVIDE TELECOMMUNICATIONS UNDERGROUND PATHWAYS IN ACCORDANCE WITH THE CAMERA AREA NETWORK DIAGRAM.

1 REVISION 1; PREVIOUS VERSIONS OF THIS DRAWING SHALL NOT BE USED; DRAWING REVISED TO MOVE ELECTROLIERS FROM NORTH SIDE OF PROPERTY TO SOUTH SIDE OF PROPERTY; REDUCE NUMBER OF ELECTROLIERS FROM 9 TO 8; RENUMBER ELECTROLIERS, L1 TO L8, FROM LEFT TO RIGHT; RELOCATE CCTV CAMERA NODES, RENUMBER CCTV CAMERA NODES TO CORRESPOND WITH RENUMBERED ELECTROLIERS; THIS RENUMBERING OF ELECTROLIERS HAS IMPLICATIONS THROUGHOUT THE ELECTRICAL DESIGN PACKAGE, COORDINATE AND RED LINE DESIGNATORS ACCORDINGLY WHERE ENCOUNTERED IN THE DUE COURSE OF WORK.

Foldenauer Engineering
1105 North Blue Ridge Circle; Palmer, Alaska 99645
907-529-1959, carl@foldenauer.engineering

STATE OF ALASKA 49TH
Carl G. Foldenauer
No. EE10899
3/11/2016
Registered Professional Engineer

R&M CONSULTANTS, INC.
9101 Vanguard Drive
Anchorage, Alaska 99507
rmconsult.com• email@rmconsult.com
phone: 907.522.1707 • fax: 907.522.3403

City of Homer
DWD UPLANDS

No.	Description	Date
1	MOVE ELECTROLIERS	2/11/16

Drawn By: CF
Checked By: CF
Date: JANUARY 22, 2016
Phase: BID DOCUMENTS
Project No: 1841.05
SHEET TITLE: ELECTRICAL PLAN
SHEET NO: 26 OF 34
E1.2

C:\Users\Admin\Desktop\R&M\R&M\1841.05 Homer DWD Uplands Design\Drawings\Dir IFB Rev 1\1841.05-E1.2-Electrical Plan.dwg
Plotted 2/11/2016 4:05 PM by Admin